


01 AS BUILT FLOOR PLANS


1:100 @ A3

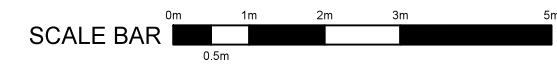


notes

1. Refer to figured dimensions, do not scale. Printed or electronic copies of the plan can be scaled for planning purposes
2. If in doubt refer to the Architect before work starts
3. All dimensions are to be checked on site
4. The Architects disclaim responsibility for variations from this drawing made without their written consent
5. Please ensure that there have been no additional revisions to this drawing before starting work.


revisions

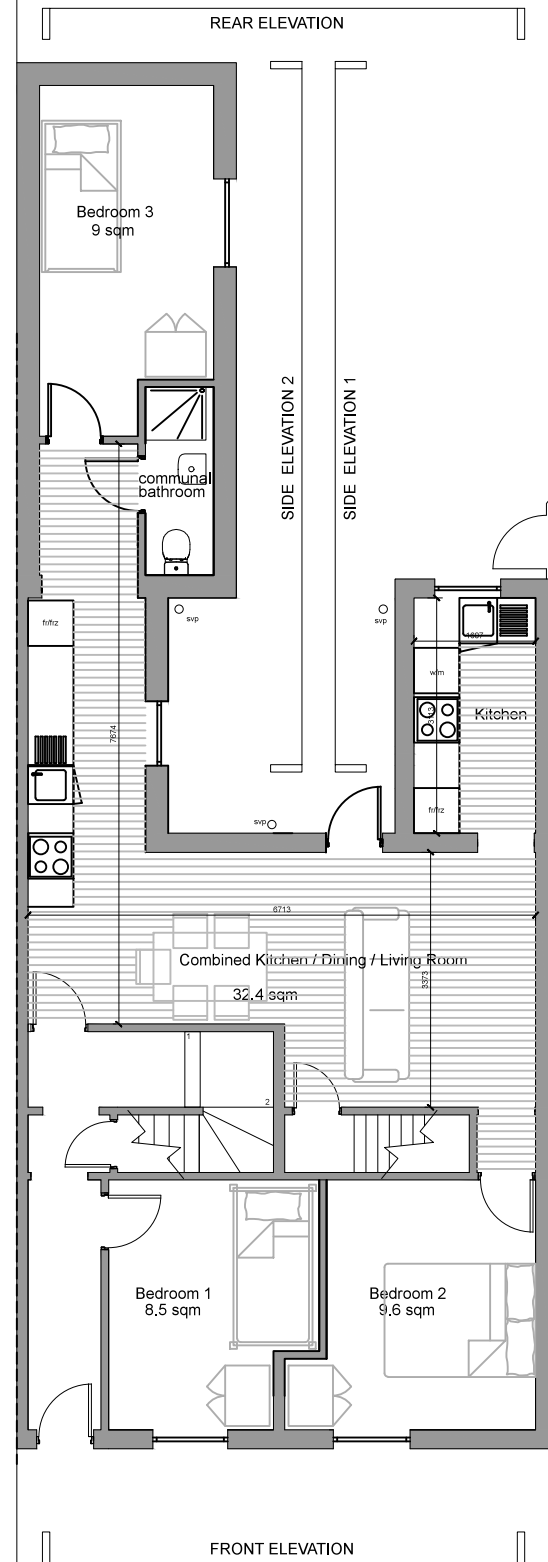

EXISTING GROUND FLOOR

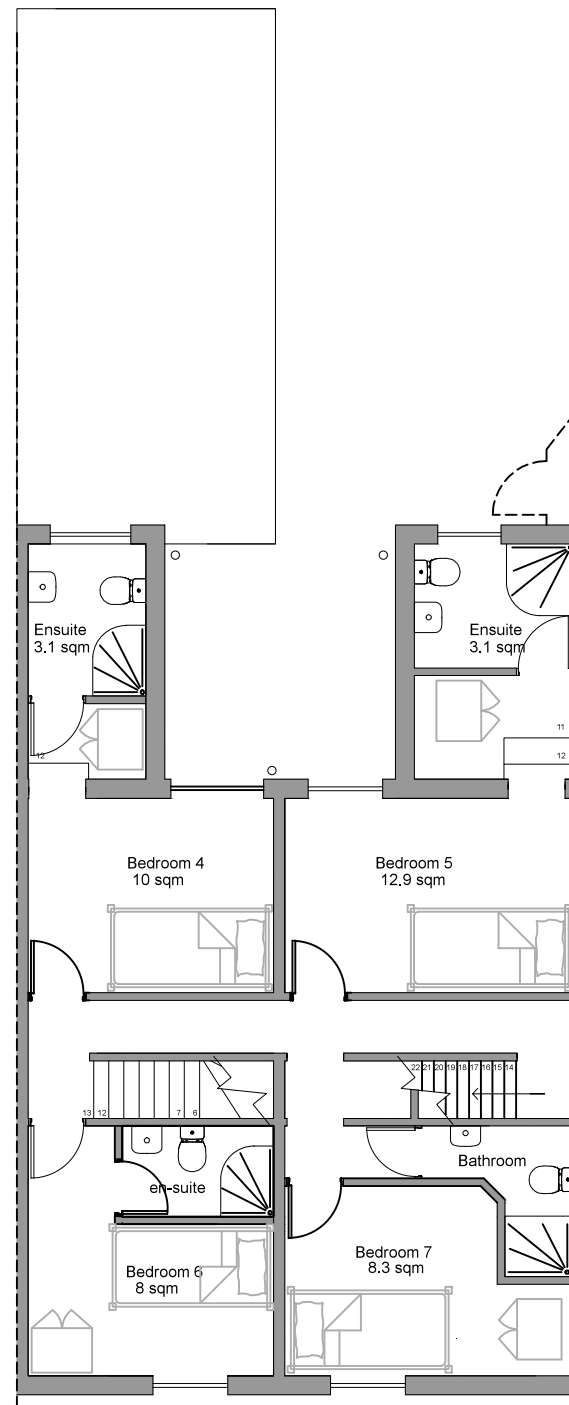

EXISTING FIRST FLOOR

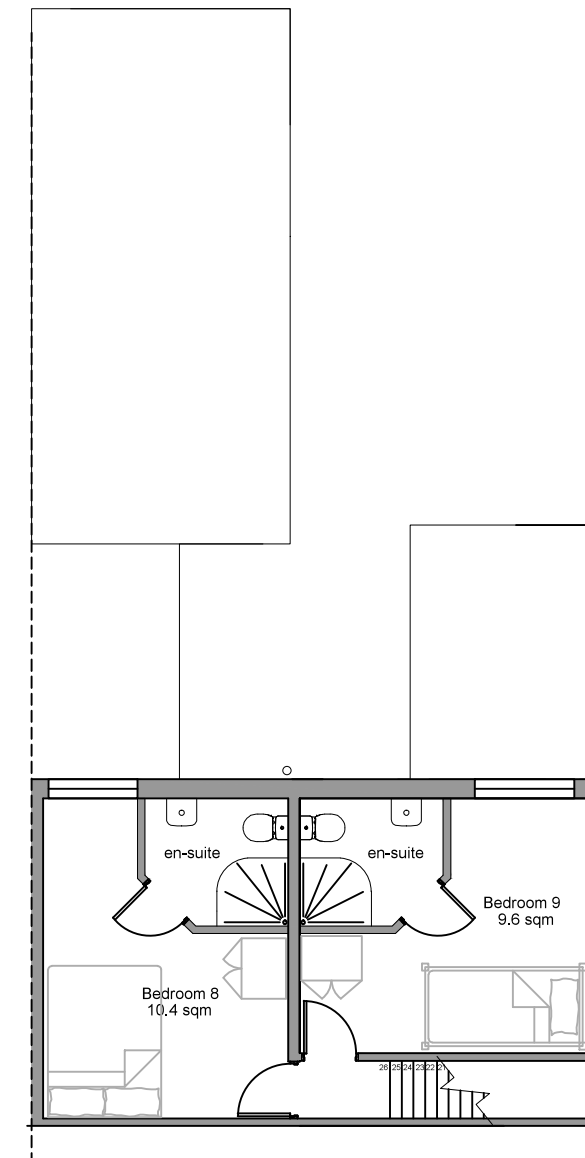

EXISTING ROOF SPACE

P.E.G. associates
Limited

client
British Living Group Ltd
job
42 Harrington St, DE23 8PG

drawing
As Built Floor Plans

scale
1:100 @ A3

date
AUGUST 2019

no.
BLG3 (07) 001

revision
A

drawn by
WTJW

t: 07867531197
e: pegassociatesltd@gmail.com
w: www.pegassociatesltd.com